


This drawing may contain Ordnance Survey Mastermap and Raster data. OS Copyright Acknowledgement.
 Information produced by HM Land Registry © Crown copyright 2019.
 © Crown copyright and database rights 2018. Ordnance Survey 0100031673.

Legend
 Red Line Boundary
 OS MasterMap

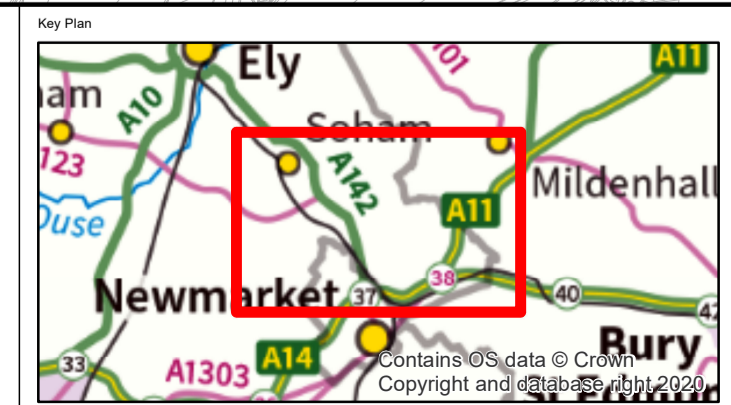

Ver	Date	Description Of Change	Tit
1	02/11/2020	FOR INFORMATION	

Consultation Change Plan
Sheet 1 of 1
Scale at A1 = 1:20,000

Project Name
 Sunnica Energy Farm DCO
 Sunnica Energy Farm Limited
 Company WSP Drawn By MW Chk/Approved JP Drawn Date 02/11/2020 Status
 Location/Level/Sheet/System Identifier
 70050915-201029-WSP-PLN-AAA-011-MW-0 Company