


This drawing may contain Ordnance Survey Mastermap and Raster data. OS Copyright Acknowledgement.
 Information produced by HM Land Registry © Crown copyright 2019.
 © Crown copyright and database rights 2018. Ordnance Survey 0100031673.

Legend
 Red Line Boundary
 OS MasterMap

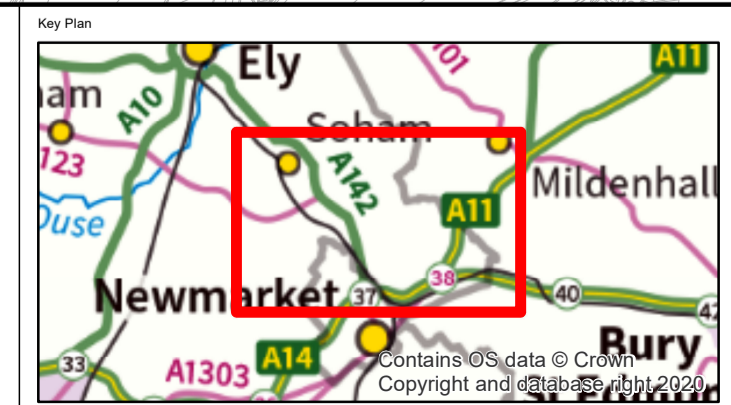

| Ver | Date | Description Of Change | Tit |
|-----|------------|-----------------------|-----|
| 1 | 30/10/2020 | FOR INFORMATION | |

Consultation Change Plan
Sheet 1 of 1
Scale at A1 = 1:20,000

Project Name
 Sunnica Energy Farm DCO
 Sunnica Energy Farm Limited
 Company WSP Drawn By MW Chk/Approved JP Drawn Date 30/10/2020 Status
 Location/Level/Subsystem Identifier
 70050915-201029-WSP-PLN-AAA-012-MW-0 Company