


This drawing may contain Ordnance Survey Mastermap and Raster data. OS Copyright Acknowledgement.  
 Information produced by HM Land Registry © Crown copyright 2019.  
 © Crown copyright and database rights 2018. Ordnance Survey 0100031673.

**Legend**  
 Red Line Boundary  
 OS MasterMap

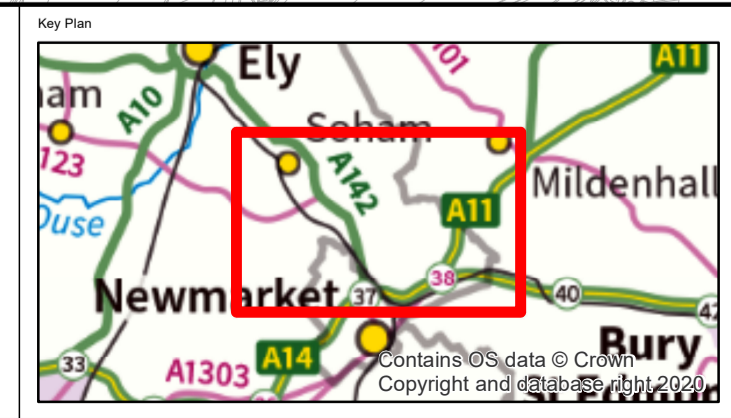

Ver	Date	Description Of Change	Tit
1	30/10/2020	FOR INFORMATION	

**Consultation Change Plan**  
 Sheet 1 of 1  
 Scale at A1 = 1:20,000

Project Name  
 Sunnica Energy Farm DCO  
 Sunnica Energy Farm Limited  
 Company WSP Drawn By MW Chk/Approved JP Drawn Date 30/10/2020 Status  
 Location-Level/Subsystem Identifier  
 70050915-201029-WSP-PLN-AAA-008-MW-0 Company